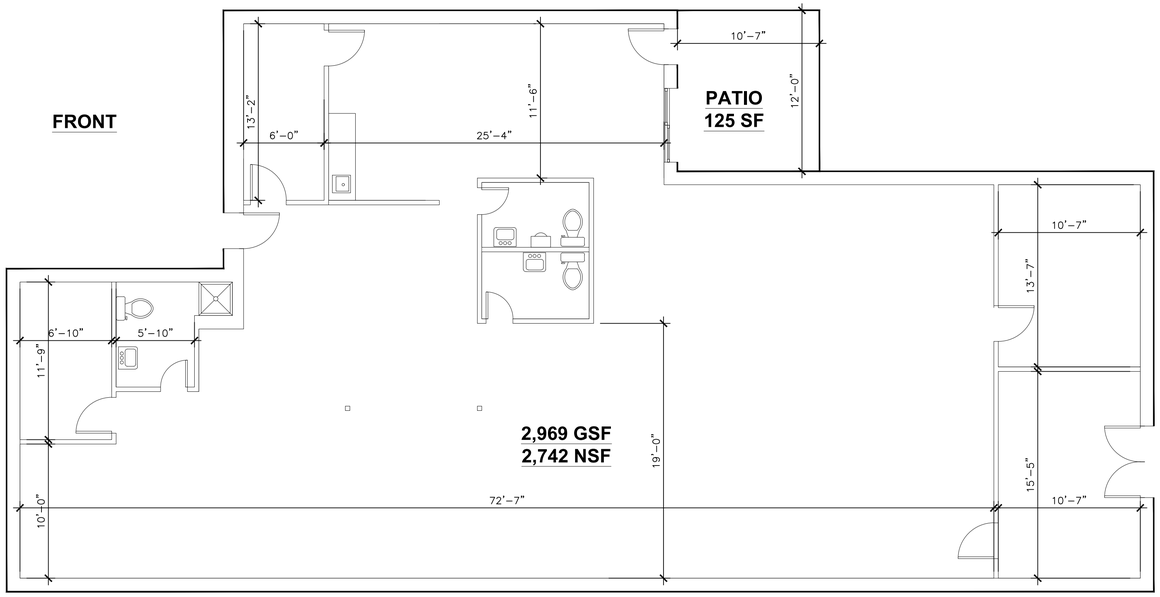

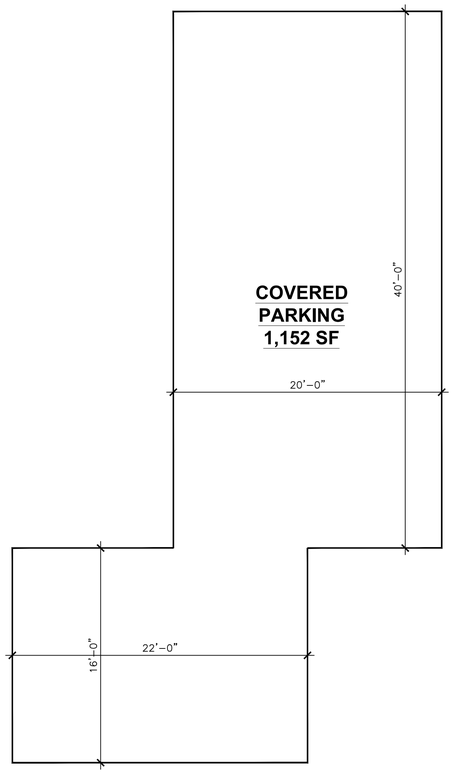

FLOOR PLAN | SCALE: 3/16"=1'-0" | 1

AMC
DESIGN

- PLANNING
- DESIGN
- CONSULTING

1549 Campbell Rd
Houston, TX 77055
PHONE: 832-274-4464
FAX: 281-598-5797
anthony_vu@comcast.net

ALL IDEAS, DESIGNS, ARRANGEMENTS AND PLANS INDICATED OR REPRESENTED BY THIS DRAWING ARE OWNED BY AMC AND ARE THE PROPERTY OF THE DESIGNER, AND WERE CREATED, EVOLVED AND DEVELOPED FOR USE IN CONNECTION WITH THE SPECIFIED PROJECT. NONE OF SUCH IDEAS, DESIGNS, ARRANGEMENTS, OR PLANS SHALL BE USED BY OR DISCLOSED TO ANY PERSON, FIRM, OR CORPORATION FOR ANY PURPOSE WHATSOEVER WITHOUT THE PRIOR PERMISSION OF THE DESIGNER. WRITTEN DIMENSIONS ON THESE DRAWINGS SHALL HAVE PRECEDENCE OVER SCALED DIMENSIONS. CONTRACTORS SHALL VERIFY AND BE RESPONSIBLE FOR ALL DIMENSIONS AND CONDITIONS ON THE JOB, AND THE DESIGNER MUST BE NOTIFIED OF ANY VARIATIONS FROM THE DIMENSIONS OR CONDITIONS SHOWN ON THESE DRAWINGS.

OFFICE AS BUILT

5710 FAIR DALE
HOUSTON, TEXAS

DRAWING ISSUED FOR:

REVISONS

	DATE:	DESCRIPTION:
△		
△		
△		
△		

DATE: 04/07/20
DRAWN BY: J.C.
CHECKED BY: A.V./J.F.
PROJECT: A.V./J.F.
FILE NO:

SHEET TITLE:
AS BUILT
PLAN

SHEET NO:
AB-1.0